


F H W A REGION NO.	STATE	FED. AD PROJ. NO.	SHEET NO.	TOTAL SHEETS
3	MD			




MD 355 IS ASSUMED TO RUN  
IN A NORTH-SOUTH DIRECTION.


### SIGNS

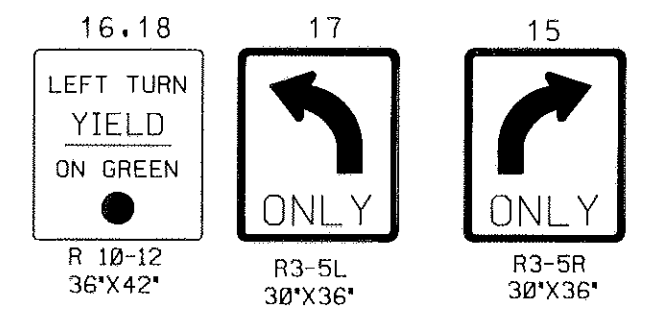


### SIGNALS

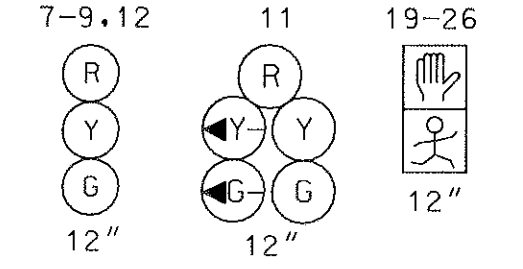

### NEMA PHASING

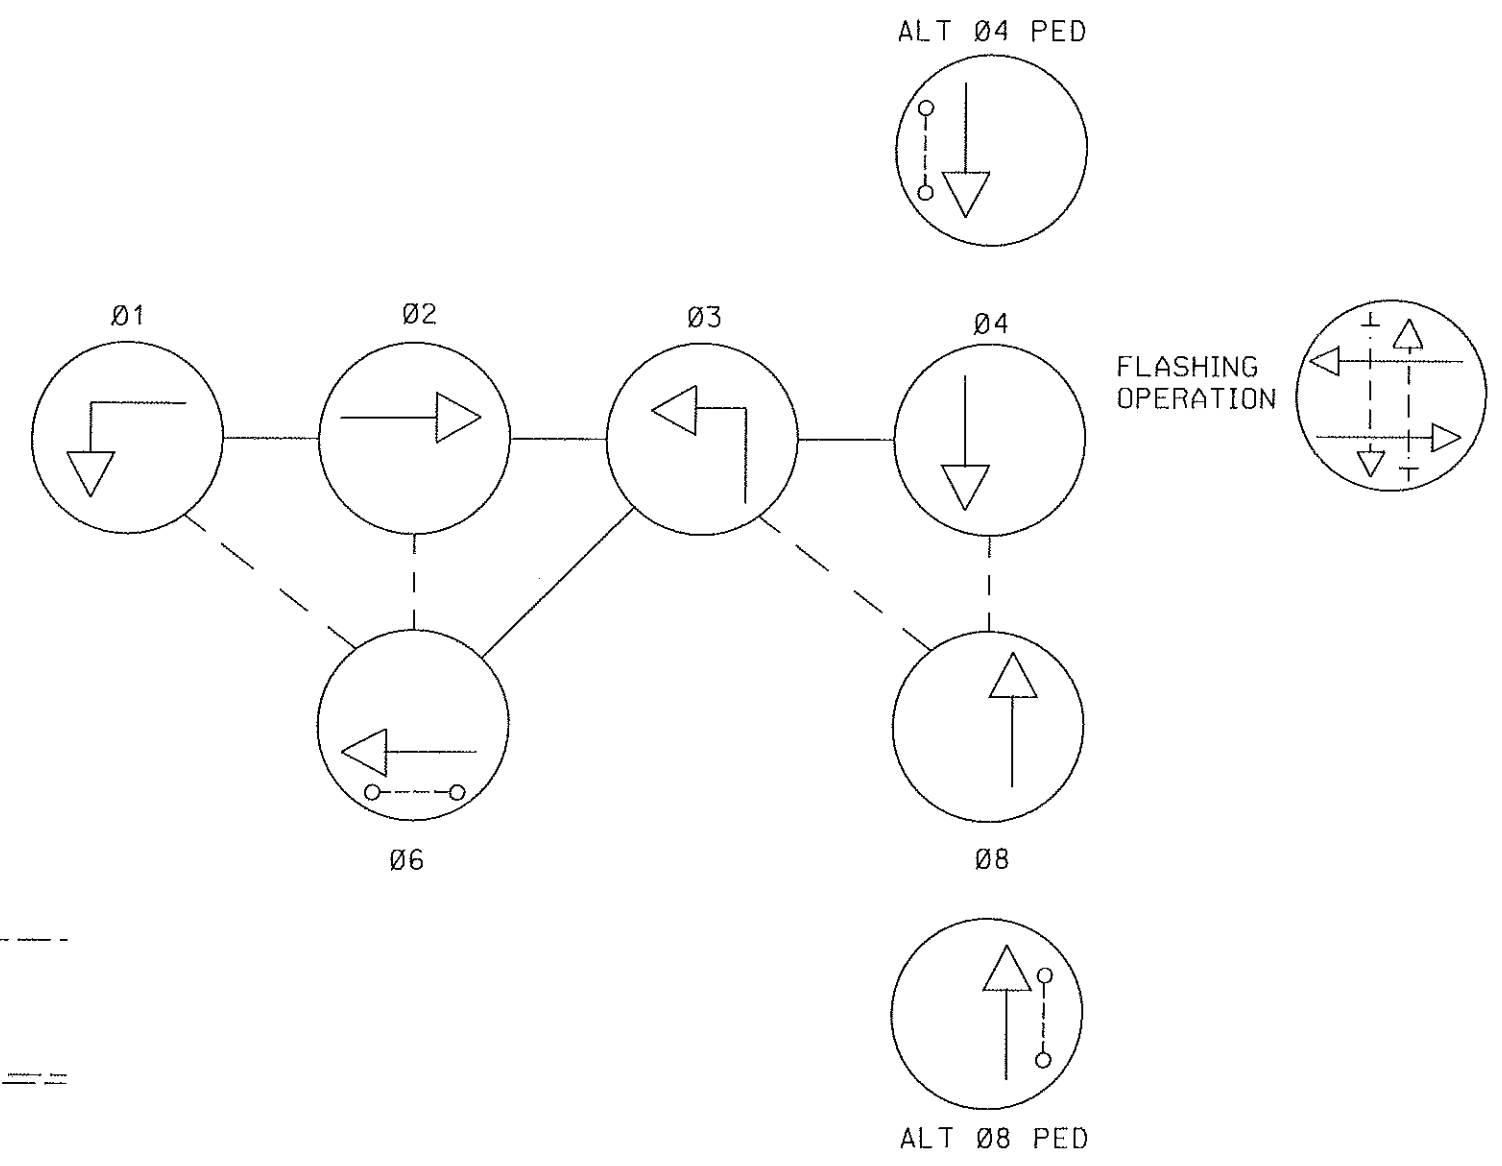

PHASING NOTES:  
1. PHASES ASSOCIATED BY A DASHED LINE WILL OPERATE CONCURRENTLY.  
2. PHASES ASSOCIATED BY A SOLID LINE WILL NOT OPERATE CONCURRENTLY.

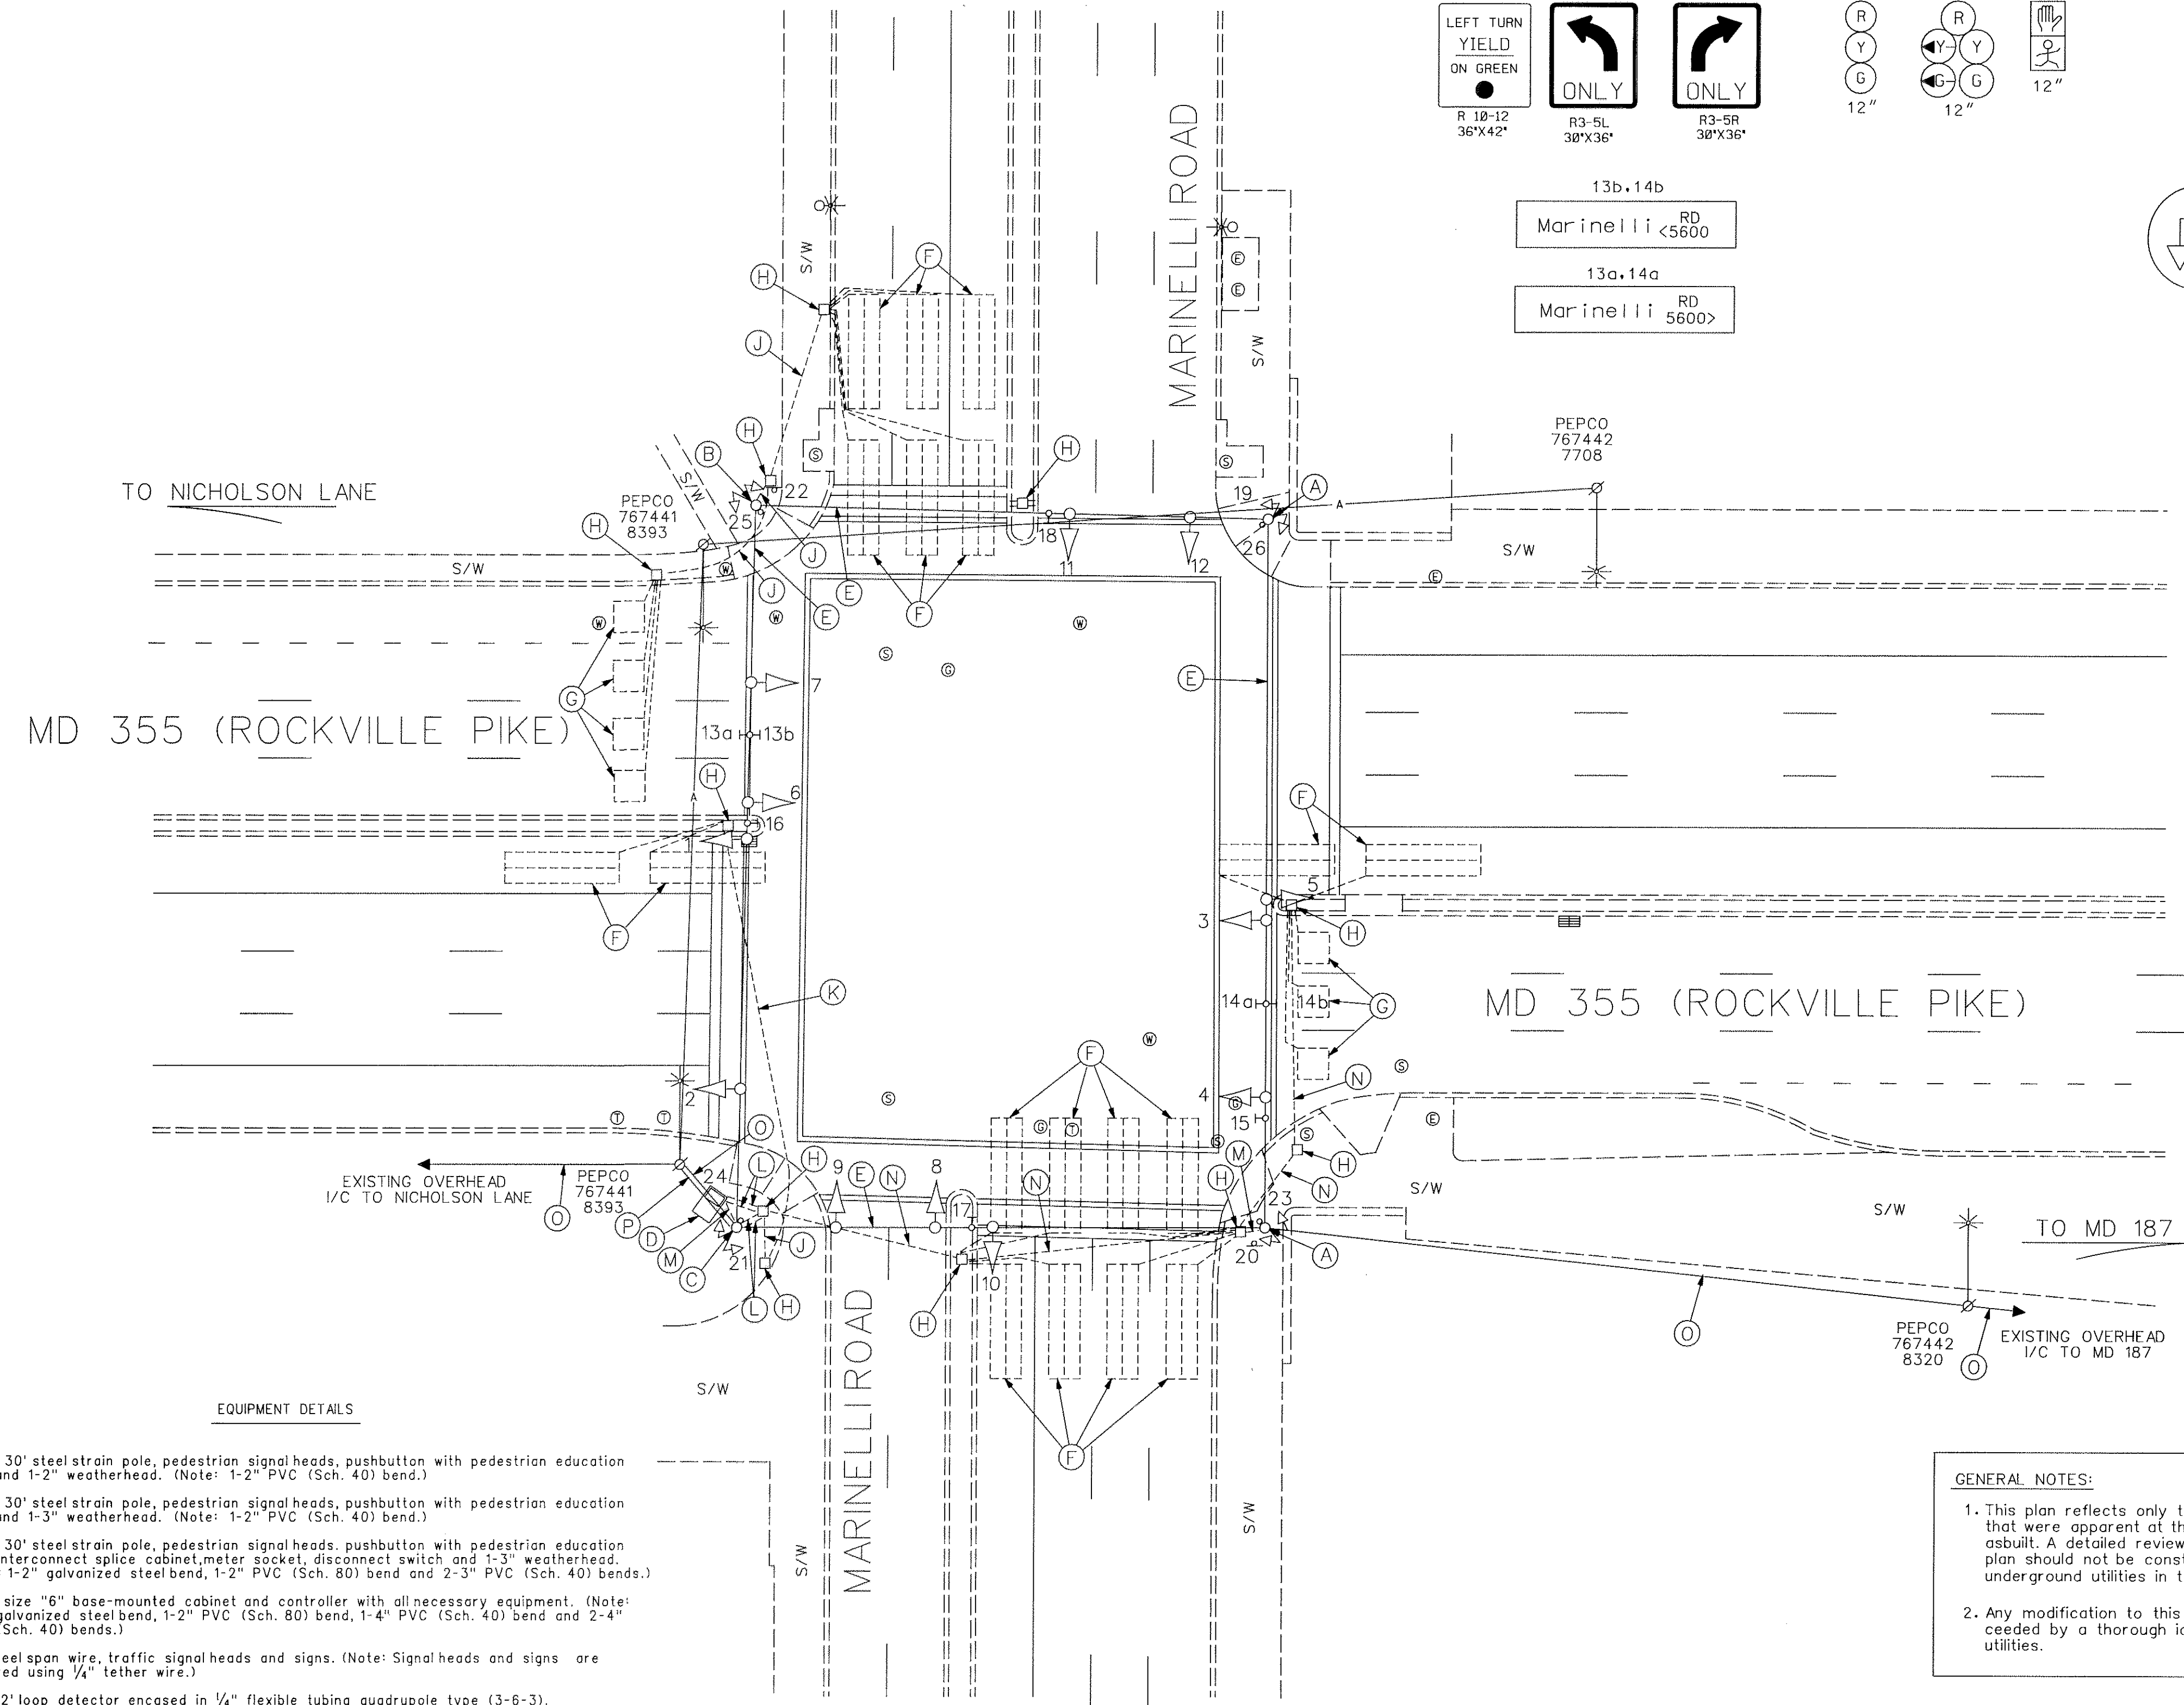


### EQUIPMENT DETAILS

- A. 12" x 30' steel strain pole, pedestrian signal heads, pushbutton with pedestrian education sign and 1-2" PVC (Sch. 40) bend. (Note: 1-2" PVC (Sch. 40) bend.)
- B. 12" x 30' steel strain pole, pedestrian signal heads, pushbutton with pedestrian education sign and 1-3" weatherhead. (Note: 1-2" PVC (Sch. 40) bend.)
- C. 12" x 30' steel strain pole, pedestrian signal heads, pushbutton with pedestrian education sign, interconnect splice cabinet, meter socket, disconnect switch and 1-3" weatherhead. (Note: 1-2" galvanized steel bend, 1-2" PVC (Sch. 80) bend and 2-3" PVC (Sch. 40) bends.)
- D. NEMA size "6" base-mounted cabinet and controller with all necessary equipment. (Note: 1-2" galvanized steel bend, 1-2" PVC (Sch. 80) bend, 1-4" PVC (Sch. 40) bend and 2-4" PVC (Sch. 40) bends.)
- E. 3/8" steel span wire, traffic signal heads and signs. (Note: Signal heads and signs are tethered using 1/4" tether wire.)
- F. 6' x 22' loop detector encased in 1/4" flexible tubing quadrupole type (3-6-3).
- G. 6' x 6' loop detector encased in 1/4" flexible tubing (4-turns).
- H. Handhole.
- J. 2" polyvinyl chloride electrical conduit (Sch. 80).
- K. 3" polyvinyl chloride electrical conduit (Sch. 80).
- L. 4" polyvinyl chloride electrical conduit (Sch. 80).
- M. 2" galvanized steel electrical conduit.
- N. 3" galvanized steel electrical conduit.
- O. Existing overhead interconnect cable.
- P. Existing overhead electrical service by PEPCO.

### GENERAL NOTES:

- 1. This plan reflects only those underground utilities that were apparent at the time of this location being asbuilt. A detailed review was not undertaken and this plan should not be construed as representing all underground utilities in the area.
- 2. Any modification to this subject signal should be preceded by a thorough identification of all existing utilities.

### UTILITY LEGEND

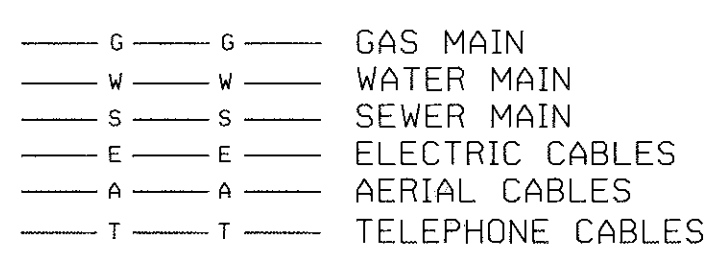

REVISION "C" ASBUILT

STREET TRAFFIC STUDIES, LTD.  
Gateway International  
1302 Concourse Drive, Suite 104  
Linthicum, Maryland 21090  
Ph (410) 859-3553  
Fax (410) 859-3579

31360.DGN

REVISIONS	APPROVALS
9-9-97 ASBUILT	ASST. CHIEF TEDD SECTION
RRZ	ASST. DISTRICT ENGINEER, TRAFFIC
B INSTALL PUSHBUTTON/PED SIGNAL ACROSS NORTH LEG OF MD 355	CHIEF, TRAFFIC ENGINEERING DESIGN DIVISION
MEL A 5-91 ASBUILT SHA NO.:	DIRECTOR, TRAFFIC & SAFETY
MEL	

MARYLAND DOT - STATE HIGHWAY ADMINISTRATION  
Office of Traffic & Safety  
TRAFFIC ENGINEERING DESIGN DIVISION  
MD 355 AND MARINELLI ROAD

DRAWN BY: TEL	COUNTY: MONTGOMERY	TS NO. TS-3162C	SHEET NO. OF
CHECK BY: WSM	LOG MILE: 15355006.39	T.I.M.S. NO.	
DATE: 10-25-79	F.A.P. NO.		
SCALE: 1" = 20'	S.H.A. NO.		